
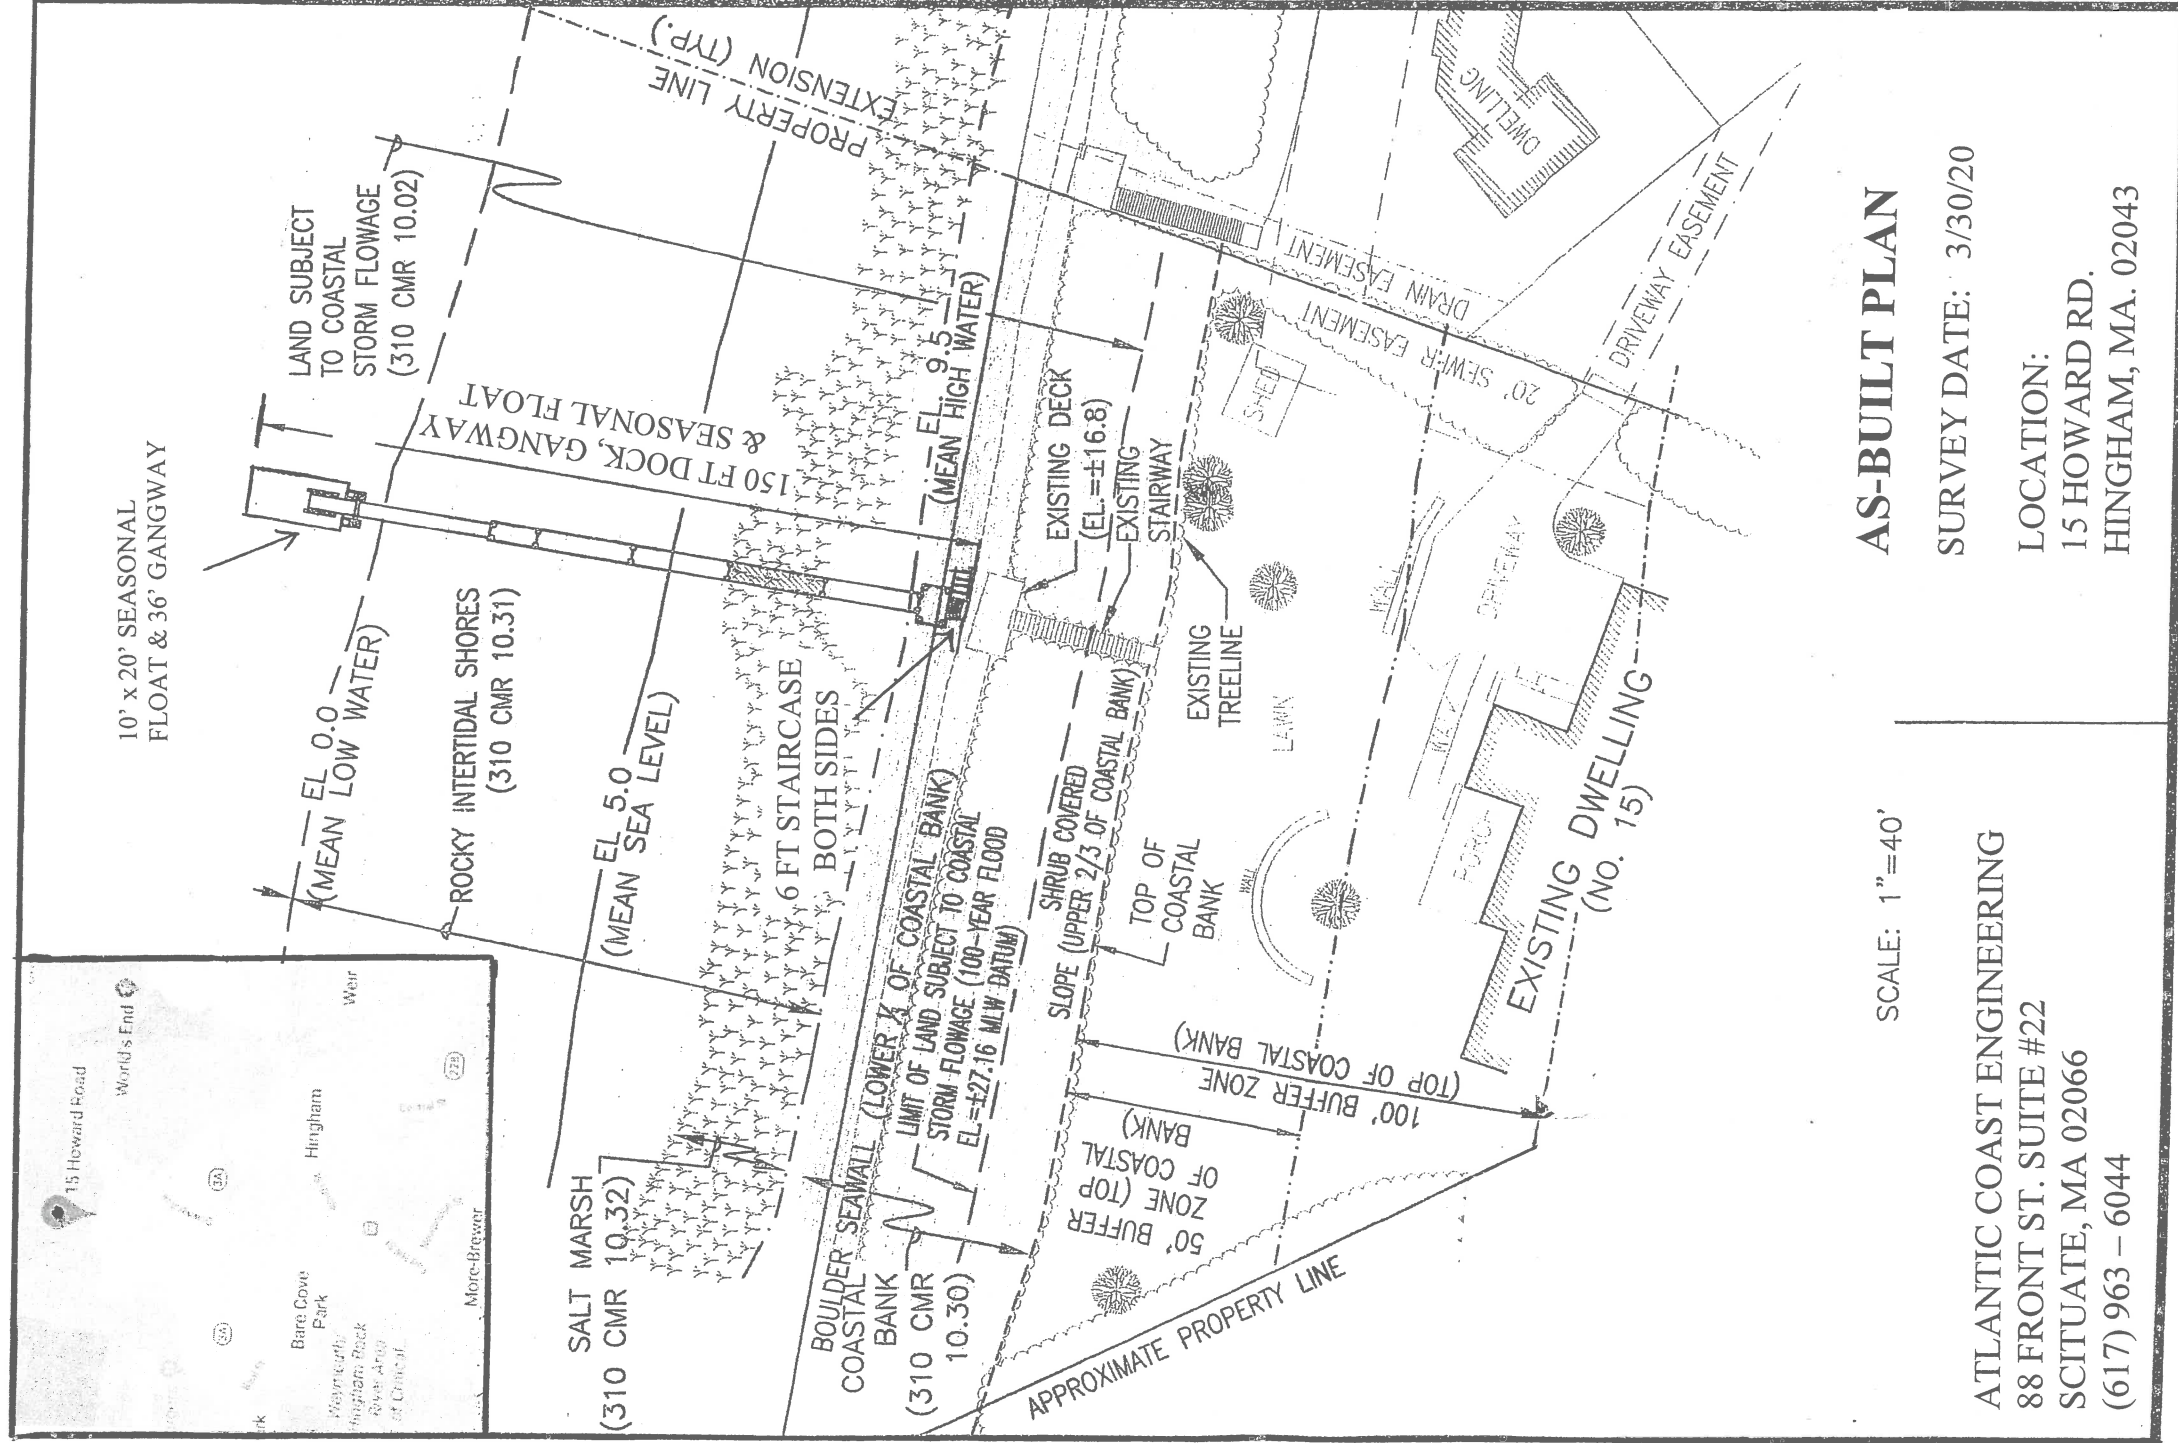


RECEIVED

APR 02 2020

TOWN OF HINGHAM  
CONSERVATION

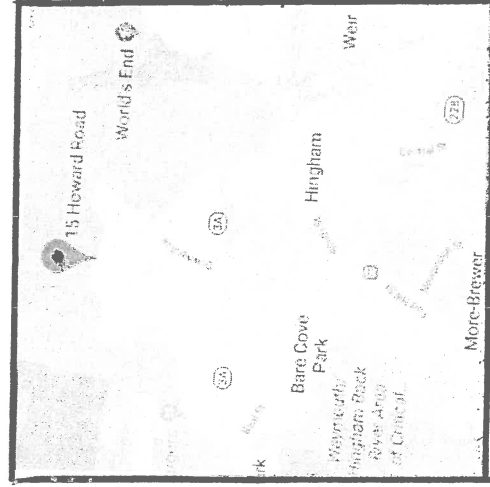

**AS-BUILT PLAN**

SCALE: 1"=40'

SURVEY DATE: 3/30/20

ATLANTIC COAST ENGINEERING  
 88 FRONT ST. SUITE #22  
 SCITUATE, MA 02066  
 (617) 963 - 6044

LOCATION:  
 15 HOWARD RD.  
 HINGHAM, MA. 02043