



LOCUS MAP

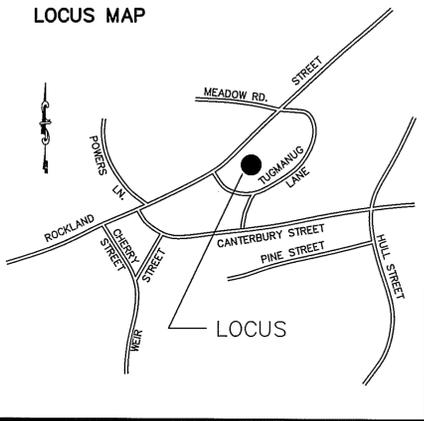

ROCKLAND (60' WIDE - STATE HIGHWAY) STREET

LOT 3  
33,595 S.F.  
0.77 AC.

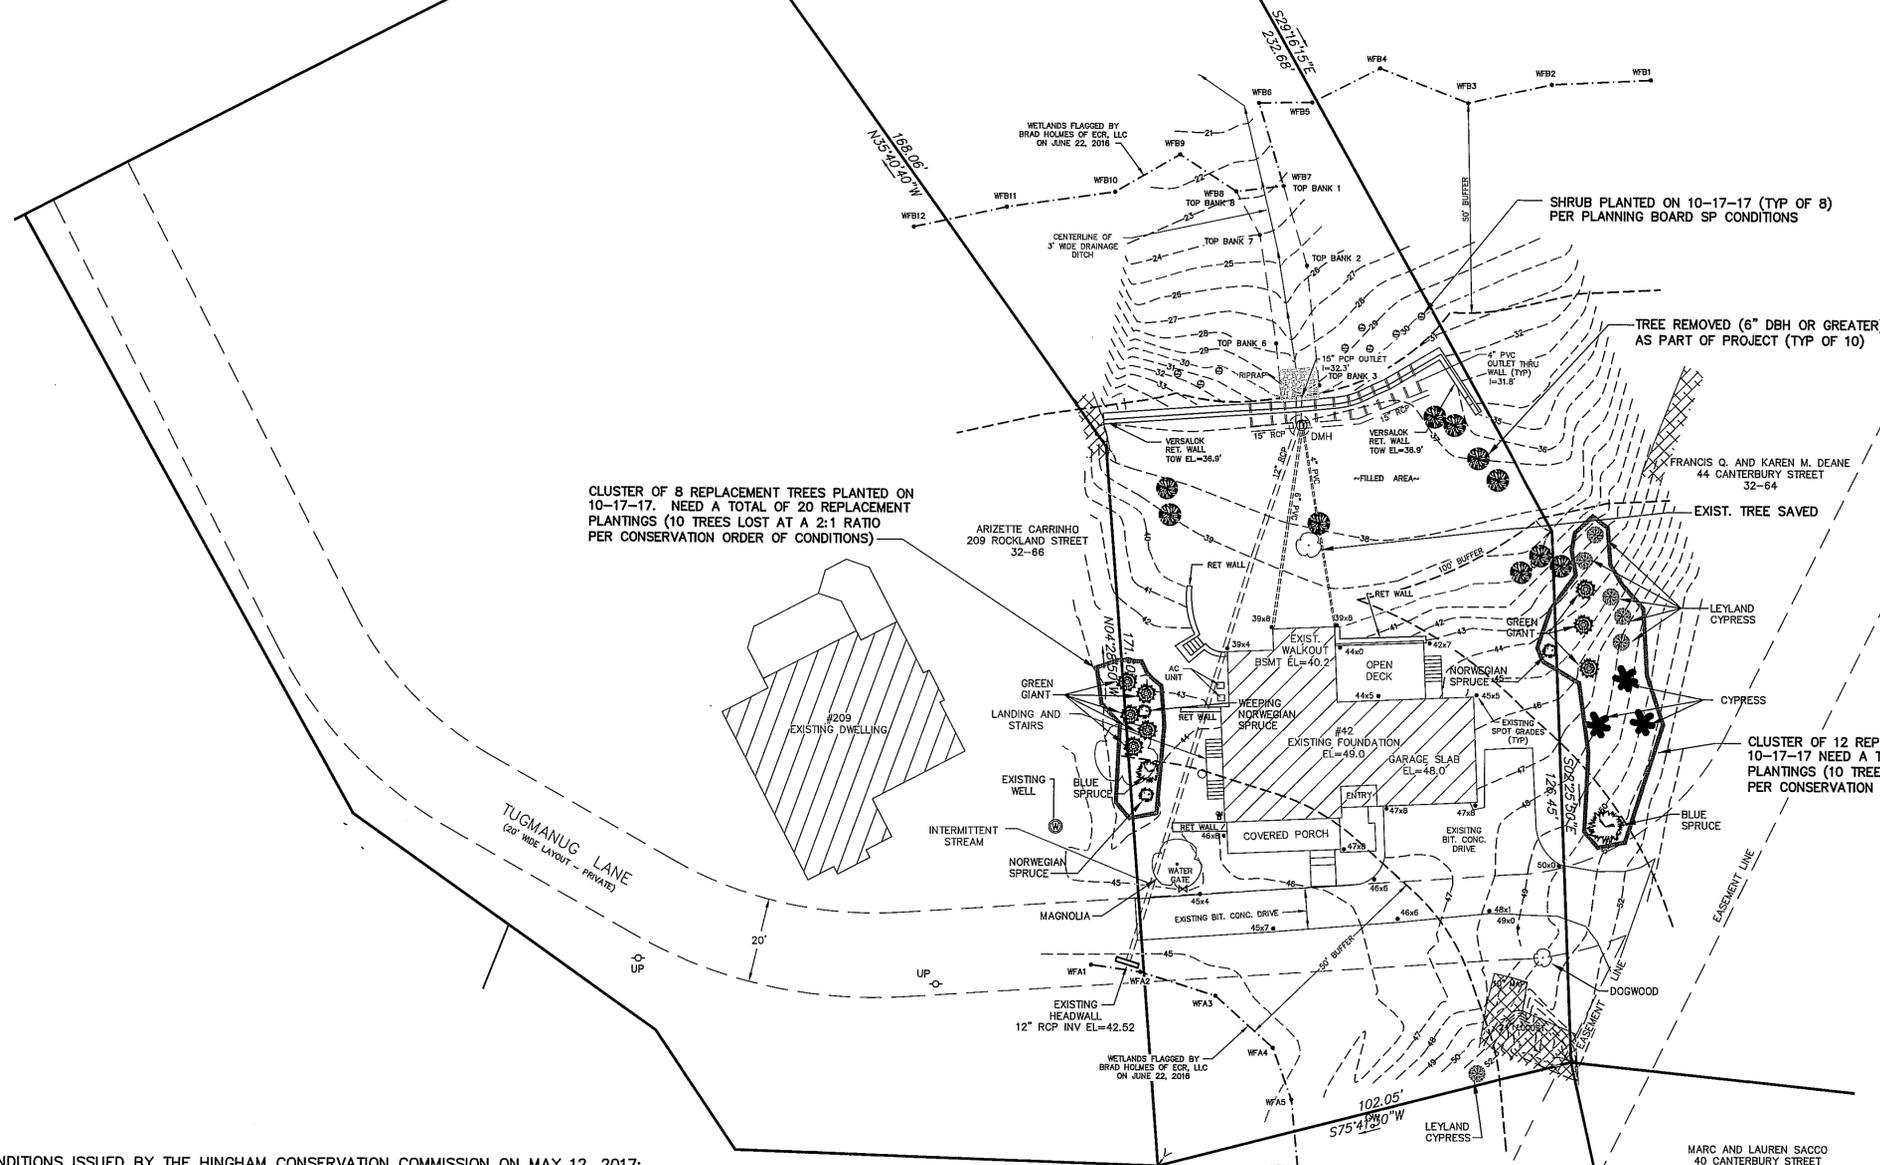

CLUSTER OF 8 REPLACEMENT TREES PLANTED ON 10-17-17. NEED A TOTAL OF 20 REPLACEMENT PLANTINGS (10 TREES LOST AT A 2:1 RATIO PER CONSERVATION ORDER OF CONDITIONS)

TREE REMOVED (6" DBH OR GREATER) AS PART OF PROJECT (TYP OF 10)

CLUSTER OF 12 REPLACEMENT TREES PLANTED ON 10-17-17 NEED A TOTAL OF 20 REPLACEMENT PLANTINGS (10 TREES LOST AT A 2:1 RATIO PER CONSERVATION ORDER OF CONDITIONS)



I CERTIFY TO THE HINGHAM CONSERVATION COMMISSION THAT THE WORK FOR THIS PROJECT HAS BEEN PERFORMED IN ACCORDANCE WITH THE APPROVED PLAN AND ORDERS OF CONDITIONS.

*Gregory J. Tansley* 7-17-20  
PROFESSIONAL ENGINEER DATE

| NO. | DATE    | DESCRIPTION               | BY  |
|-----|---------|---------------------------|-----|
| 1   | 7-20-20 | LOC. MITIGATION PLANTINGS | GJT |

OWNER/APPLICANT


NATHANIEL A. RAND AND PAIGE WOODSUM RAND  
42 CANTERBURY STREET  
HINGHAM, MA 02043  
617-833-1191

CERTIFICATE OF COMPLIANCE  
AS-BUILT PLAN  
MASS DEP FILE NO. 034-1289  
FOR  
42 CANTERBURY STREET  
IN  
HINGHAM, MASS.

SCALE: 1"=20' DEC. 7, 2017

ROSS ENGINEERING COMPANY INC.  
PROFESSIONAL ENGINEERS - LAND SURVEYORS

683 MAIN STREET  
NORWELL, MASS. 02061  
(617)659-1325

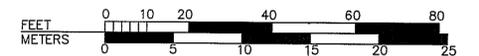

NOTES:

- SEE ORDER OF CONDITIONS ISSUED BY THE HINGHAM CONSERVATION COMMISSION ON MAY 12, 2017; RECORDED INTO MASSACHUSETTS LAND REGISTRATION SYSTEM AS DOC. NO. 763543.
- ASSESSOR'S REFERENCE: 32-65
- THE ORDER OF CONDITIONS REQUIRED A TOTAL OF 20 REPLACEMENT PLANTINGS FOR MITIGATION AN 8 PLANT CLUSTER TO THE WEST AND A 12 PLANT CLUSTER TO THE WEST PROVIDE THE REQUIRED 20 PLANT TOTAL. THE APPLICANT PROVIDED 3 ADDITIONAL PLANTS OUT FRONT, THE MAGNOLIA, DOGWOOD, AND THE LEYLAND CYPRESS.
- ALL REPLACEMENT PLANTINGS HAVE SURVIVED A TWO YEAR GROWING SEASON.