



JAMES E. MCGRATH, PLS  
 1734 COMMERCIAL STREET  
 WEYMOUTH, MA 02189  
 781-929-6255

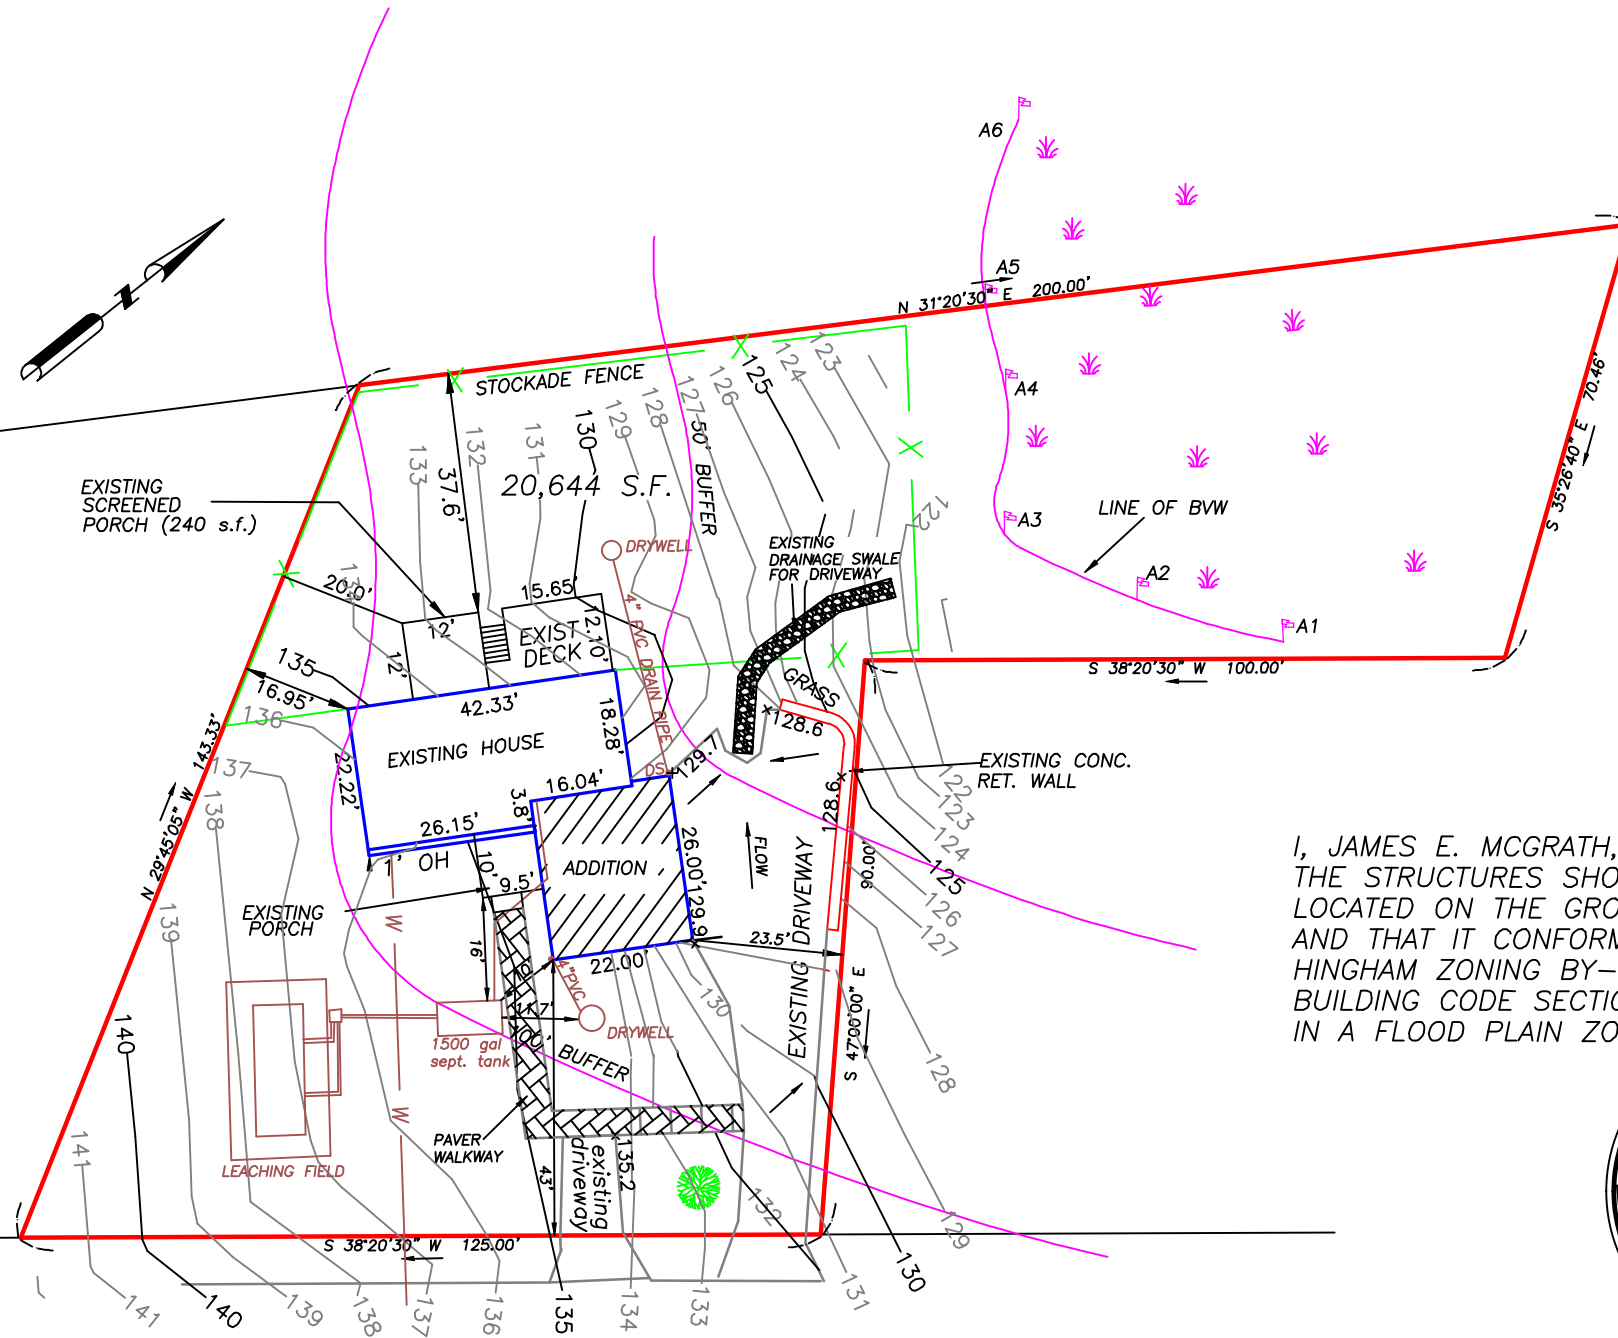

I, JAMES E. MCGRATH, HEREBY CERTIFY THAT THE STRUCTURES SHOWN ON THIS PLAN ARE LOCATED ON THE GROUND AS SHOWN HEREIN AND THAT IT CONFORMS TO THE TOWN OF HINGHAM ZONING BY-LAWS AND THE STATE BUILDING CODE SECTION 113.6, AND IS NOT IN A FLOOD PLAIN ZONE.

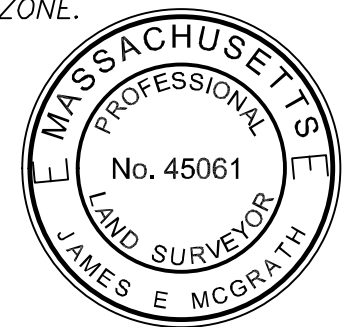

KNOLL ROAD



OWNERS: JUSTIN & MARIE VOGEL  
 DEED: BK 35058, PG 124  
 PLAN #908 OF 1964  
 ZONING DISTRICT: RESIDENCE B

**AS-BUILT PLAN  
 4 KNOLL ROAD  
 HINGHAM, MA**

SCALE: 1" = 30'  
 DATE: SEPT. 26, 2020  
 REVISED: 1/10/2021