
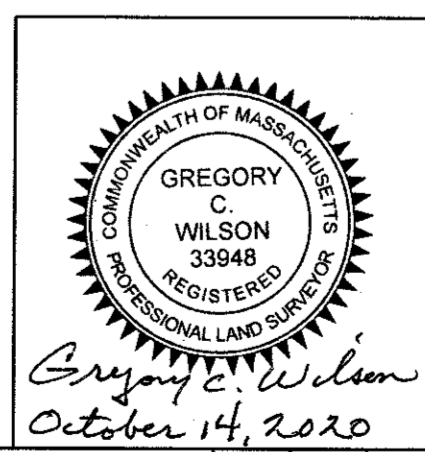
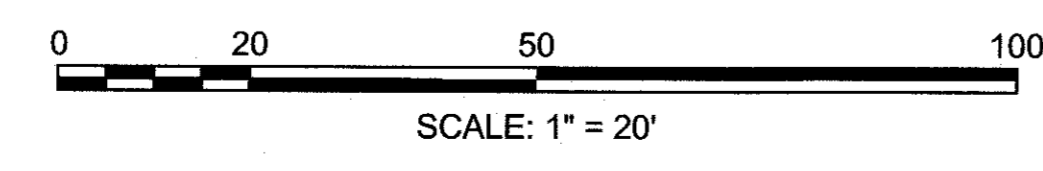


LEGEND		ABBREVIATIONS	
BM	BUSH	AC	AIR CONDITIONING UNIT
BM	BENCHMARK	BIT	BITUMINOUS
CG	BIKE PARKING	CONC	CONCRETE
CG	CATCH BASIN - SQUARE	DBYL	DOUBLE YELLOW LINE
DH	CLEAN OUT GATE	EL	ELEVATION
DH	DRILL HOLE	EP	EDGE OF PAVEMENT
EHH	DRAIN MANHOLE	FF	FINISH FLOOR
EHH	ELECTRIC HANDHOLE	GRL	GUARDRAIL
EM	ELECTRIC MANHOLE	MTL	METAL
EM	ELECTRIC METER	N/F	NOW OR FORMERLY
EB	EMERGENCY BOX	PL	PROPERTY LINE
FP	FLAG POLE	SWL	SOLID WHITE LINE
GG	GAS GATE	SYL	SOLID YELLOW LINE
GG	GAS METER	TYP	TYPICAL
IP	HANDICAP SYMBOL	TRFM	TRANSFORMER
IP	IRON PIPE	VGC	VERTICAL GRANITE CURB
MB	MAIL BOX		
POST	CIRCULAR POST		
POST	SQUARE POST		
SP	STAND PIPE		
SP	SEWER MANHOLE		
THH	TELEPHONE MANHOLE		
THH	TELEPHONE HANDHOLE		
MH	TREE		
MH	OTHER MANHOLE		
WM	SIGN		
WM	SIGN - DOUBLE POST		
WM	WATER GATE		
WM	WATER METER		

- GENERAL NOTES:**
- RECORD OWNER: N/F COMMONWEALTH OF MASSACHUSETTS DEPARTMENT OF CONSERVATION AND RECREATION;
 - DEED REFERENCE: BOOK 332, PAGE 82; CERT. OF TITLE # 66482;
 - PLAN REFERENCES: LC PLAN NO. 14401 I, J,
 - PLAN NO. 770 OF 1985, PLAN NO. 306 OF 2006, PLAN NO. 605 OF 2004,
 - PLAN NO. 191 OF 2004;
 - THE SUBJECT PROPERTY LINES WITHIN THE TOWN OF HINGHAM INDUSTRIAL DISTRICT;
 - ELEVATION BASED ON NAVD 88 DATUM;
 - THE SUBJECT PROPERTY LINES IN FEMA ZONES "X AND "VE" (EL. 14) AS SHOWN ON FEMA COMMUNITY MAP PANEL 25023C0018J DATED JULY 17, 2012 ZONE "VE" IS A SPECIAL HAZARD FLOOD ZONE;
 - UTILITIES SHOWN ON THIS PLAN ARE BASED ON OBSERVANCE OF ABOVE GROUND UTILITIES. NO WARRANTY IS EXPRESSED OR IMPLIED AS TO THE ACCURACY OF THE LOCATIONS OF SAID UTILITIES, OR THE EXISTANCE OR NON-EXISTANCE OF ANY OTHER SUCH UTILITIES;
 - THIS PLAN IS THE RESULT OF AN ON THE GROUND INSTRUMENT SURVEY PERFORMED BY C&C CONSULTING ENGINEERS, LLC IN SEPTEMBER 2020.

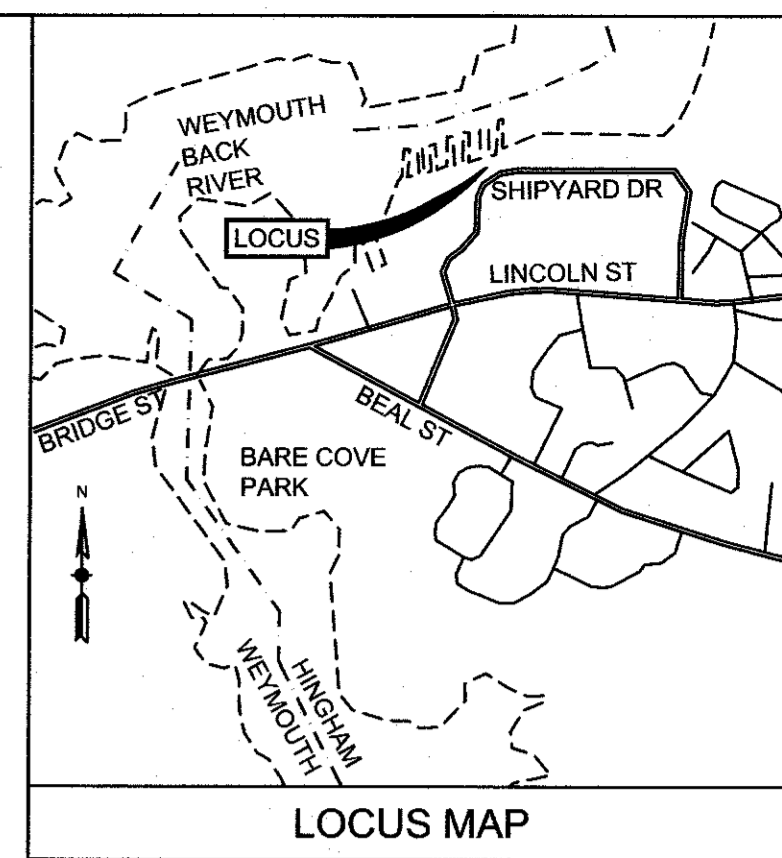

MASSACHUSETTS BAY TRANSPORTATION AUTHORITY
T
HINGHAM INTERMODAL CENTER
MBTA CONTRACT NO. Z92PS65

AS - BUILT SITE PLAN

ISSUE		DATE	DESCRIPTION	CHK'D	CHK'D	APP
PREPARED BY: C&C CONSULTING ENGINEERS, LLC 1380 SOLDIERS FIELD ROAD, BOSTON, MA 02115 617-254-0920 (VOICE) 617-254-7631 (FAX)						
APPROVED BY: WSP USA Inc. 100 SUMMER ST. BOSTON, MA 02110 TEL: 617-426-7330			APPROVED BY: MASSACHUSETTS BAY TRANSPORTATION AUTHORITY			
PROJECT MANAGER	DATE	PROJECT MANAGER	DATE			
SCALE: 1"=20'	DRAWN BY: MG	FIELD BY: HF	CHECK BY: GCW	PLAN NO.	ISSUE	
DATE: OCT. 2020				SHEET 1 OF 1		