


ENLARGED SCALE PLAN - FENCING PLAN
SCALE: N.T.S.

NOTES:

1. SITE SURVEY PERFORMED ON JULY 16, 2007.
2. SITE WET LAND FLAGGING PERFORMED BY :

SUSAN McARTHUR, WETLAND RESOURCE SPECIALIST
455 EDGELL ROAD, FRAMINGHAM, MA 01071
smcarthur@rcn.com 508-788-6052

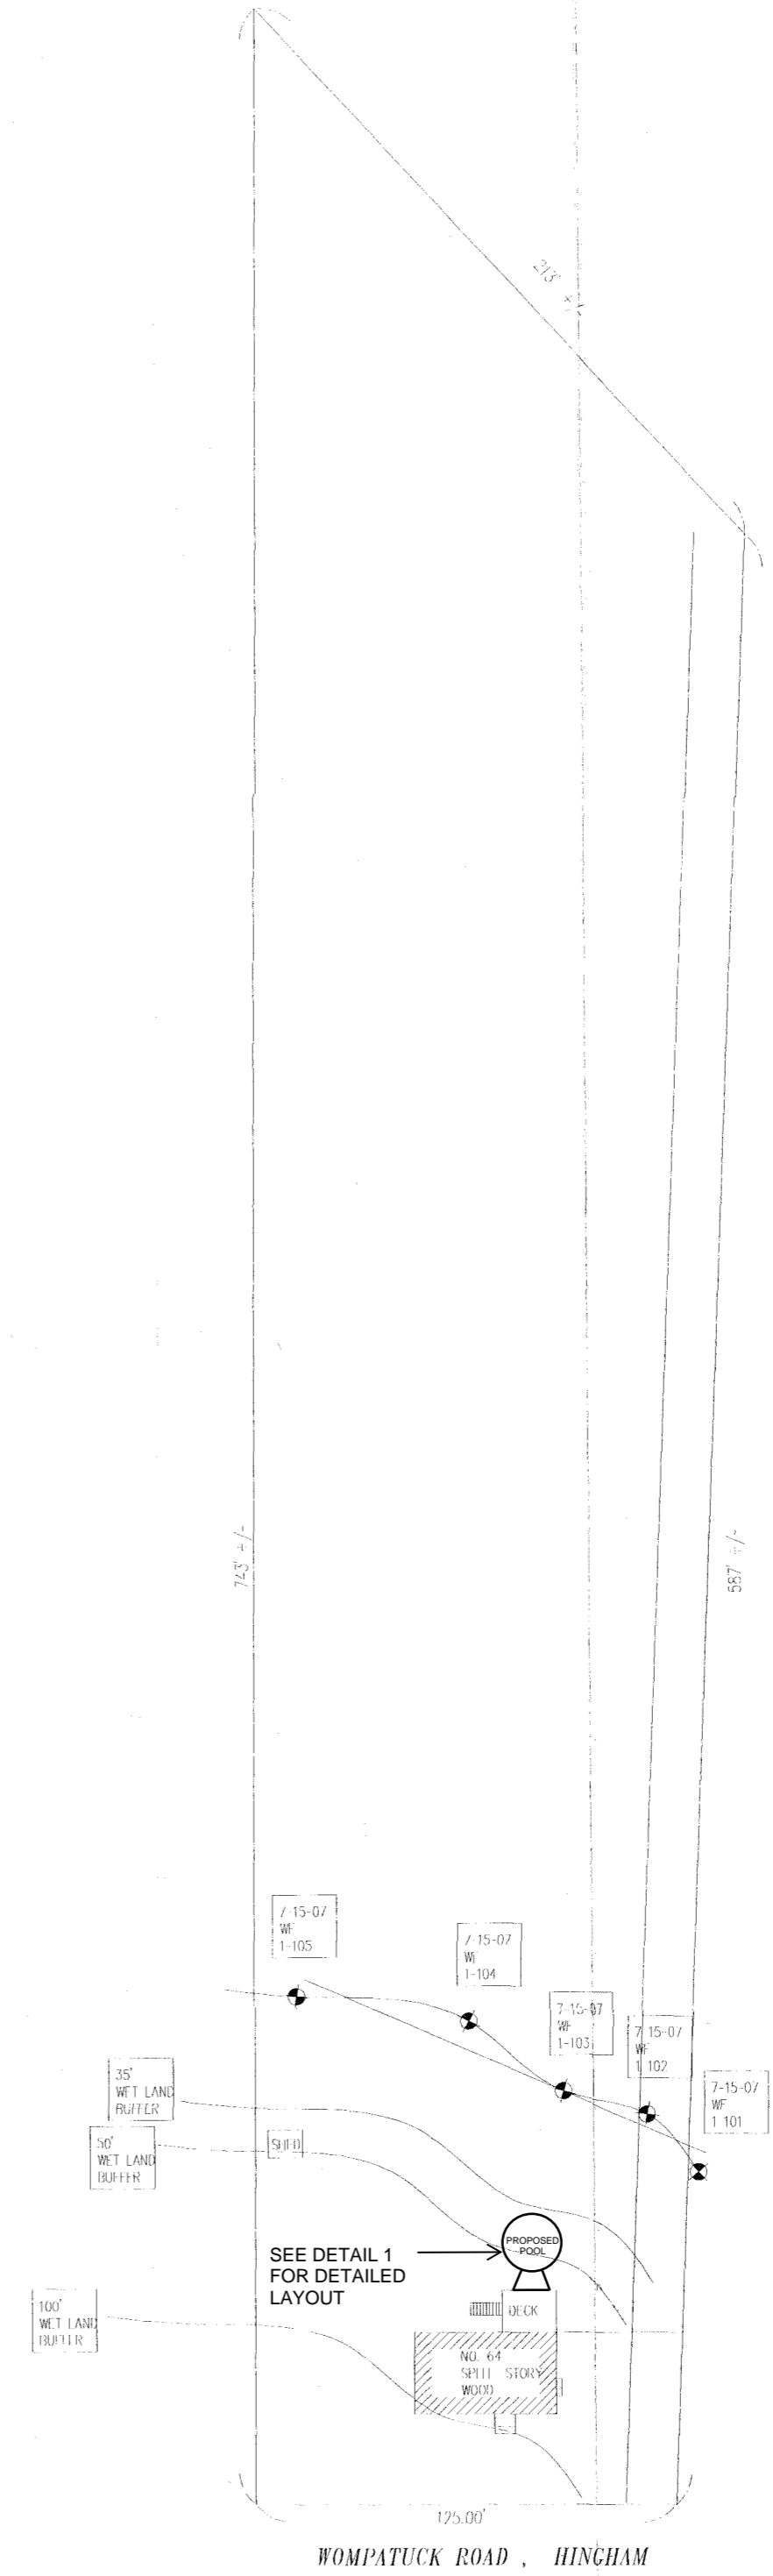

64 WOMPATUCK ROAD
HINGHAM, MASSACHUSETTS


KIERAN & KAREN
GUINAN

PROPOSED
SWIMMING POOL

REVISIONS:

REV. No.	COMMENTS	DATE
1	AS-BUILT CONDITIONS	03/21

STAMP	STAMP

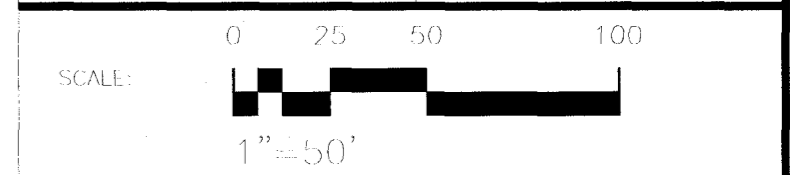

DATE: JULY 25, 2007	DRAWING No. E-1
DRAWN BY: L.O.B.	
CHECKED BY: L.O.B.	
APPROVED BY: L.O.B.	